


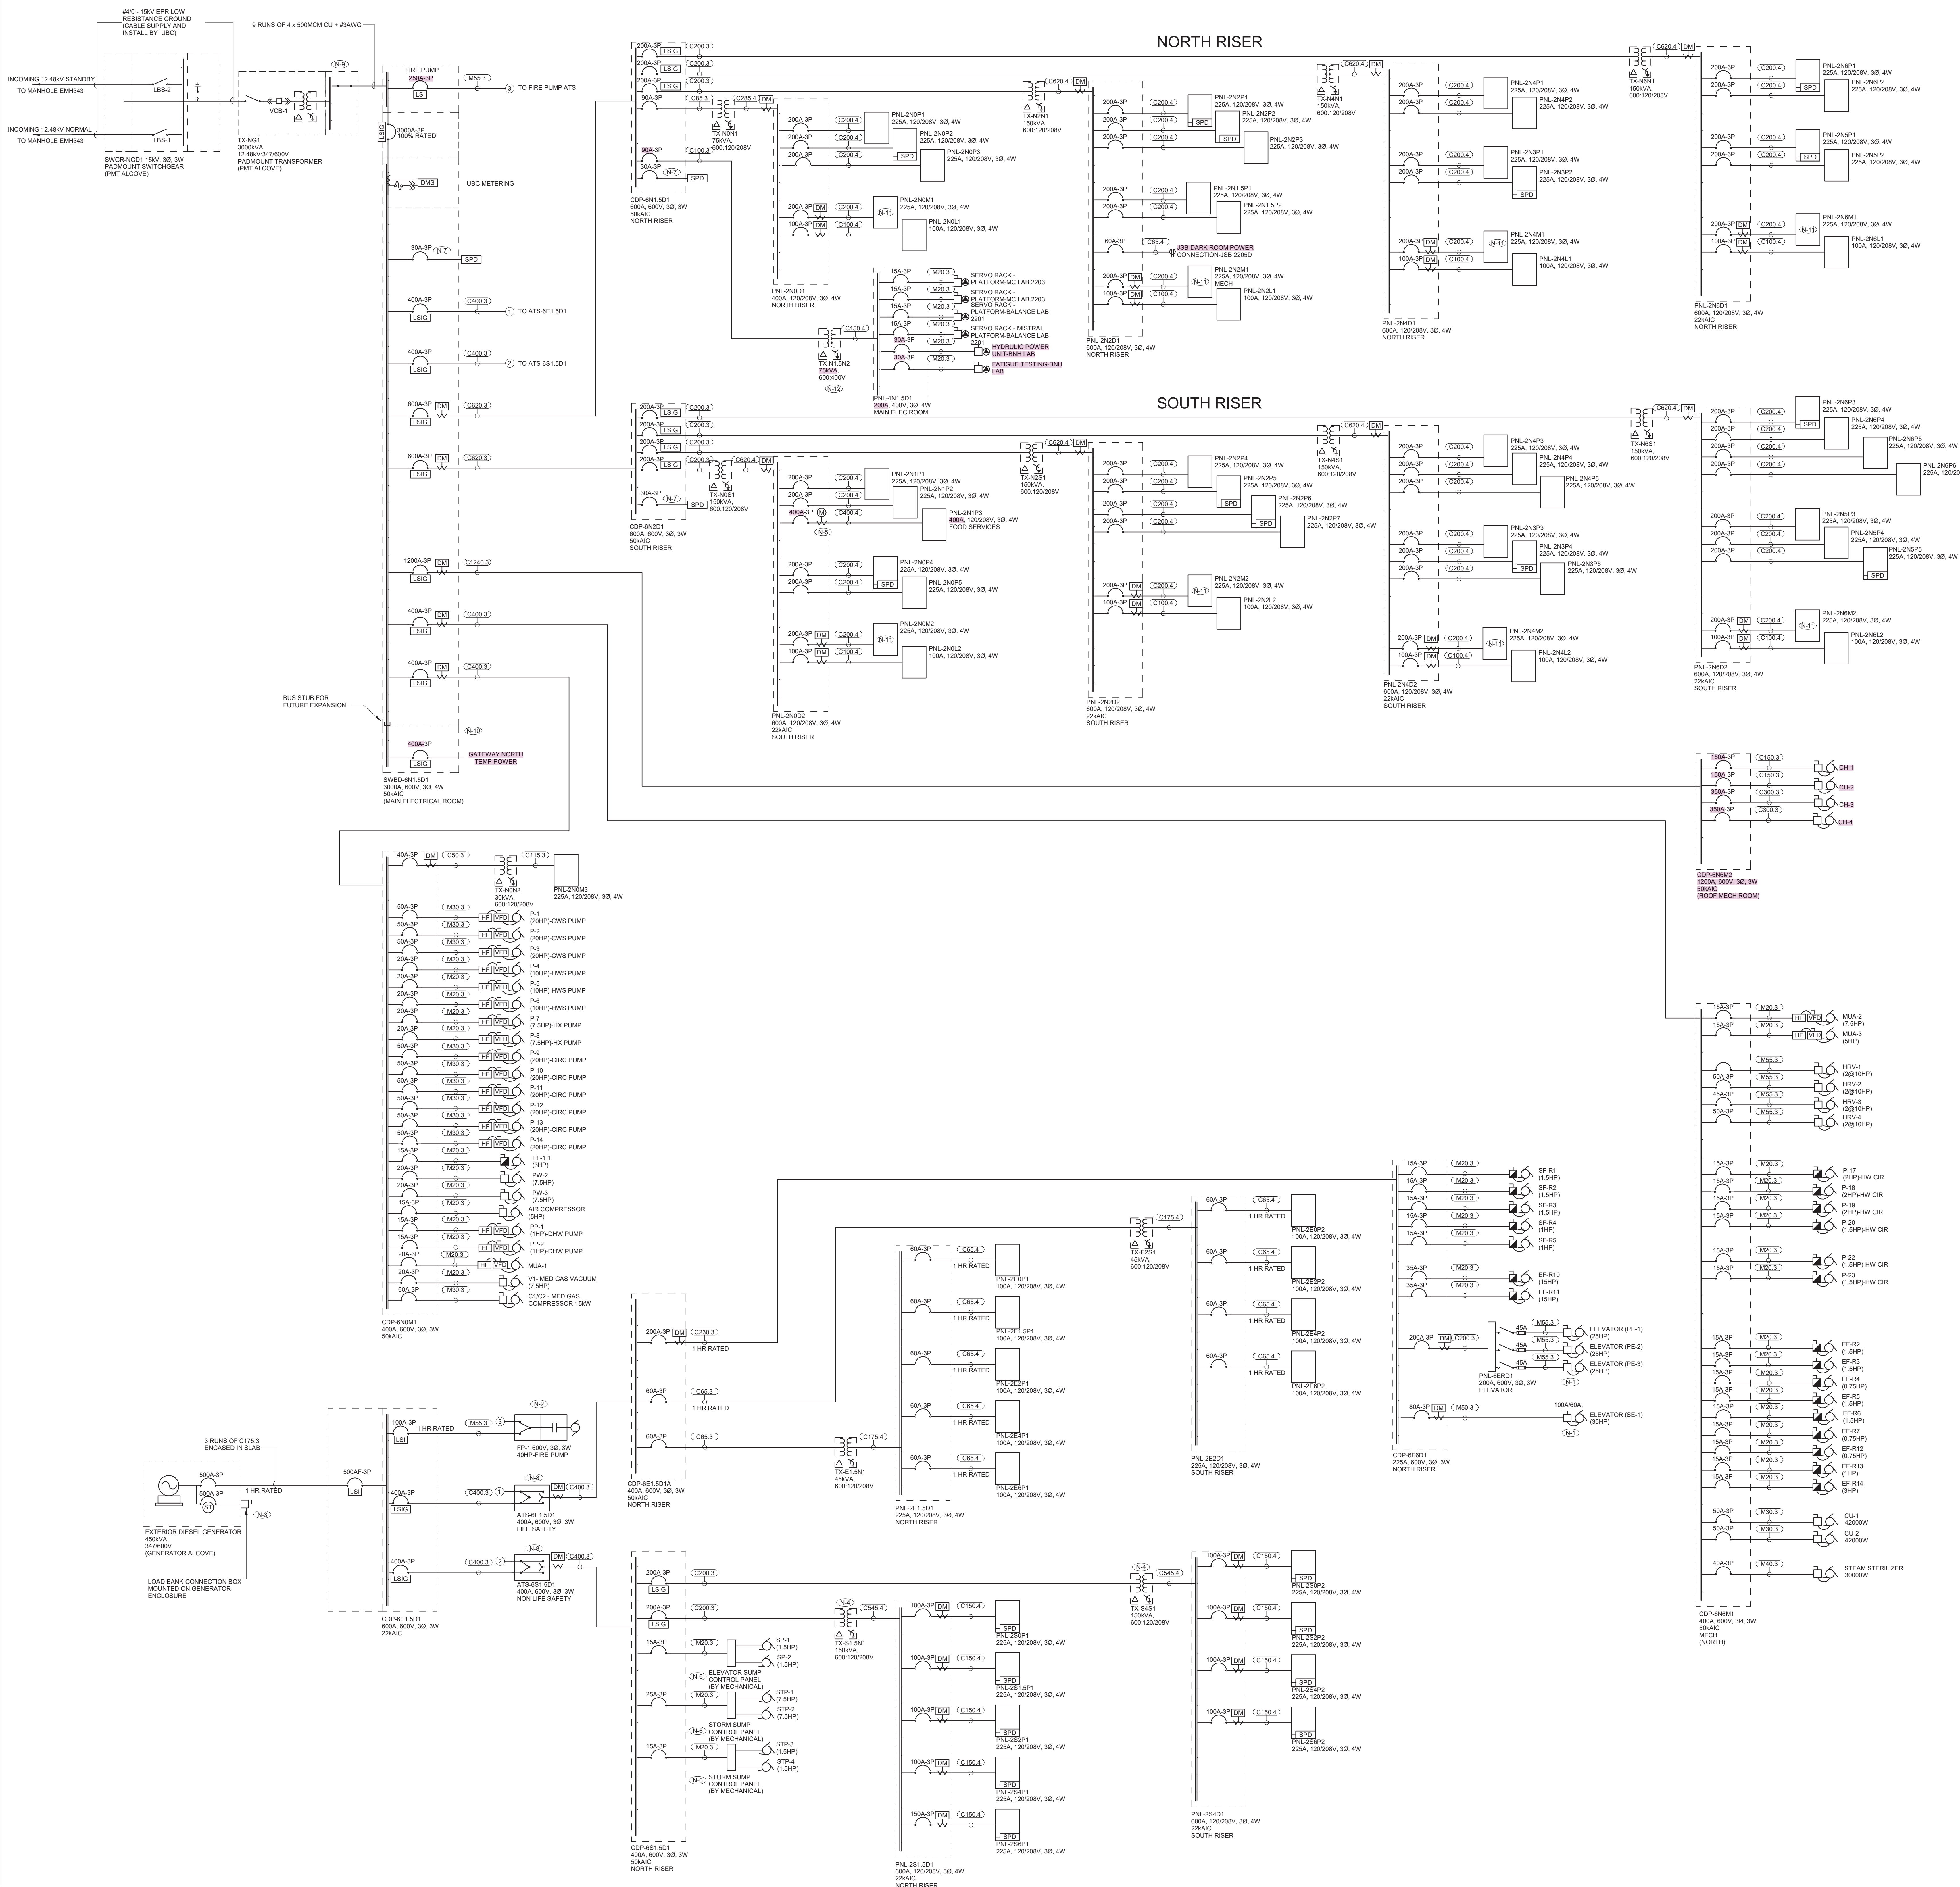

- GENERAL NOTES:
- ELECTRICAL CONTRACTOR SHALL COORDINATE INCOMING HIGH VOLTAGE ELECTRICAL SERVICE WITH UBC ENERGY & WATER SERVICES.
 - ALL VFDs & HARMONIC FILTERS SUPPLIED BY MECHANICAL CONTRACTOR. ALL LINE AND LOAD SIDE WIRING FOR VFDs AND ASSOCIATED HARMONIC FILTERS TO BE BY THE ELECTRICAL CONTRACTOR. COORDINATE THE EXACT LOCATIONS OF VFDs AND HARMONIC FILTERS ON SITE WITH THE MECHANICAL CONTRACTOR. TYPICAL FOR ALL VFDs AND FILTERS.
 - ELECTRICAL CONTRACTOR TO PROVIDE COORDINATION STUDY PER SPECIFICATIONS AND CONFIRM PANEL, MISC RATINGS AND BREAKER COORDINATION PRIOR TO RELEASE OF ELECTRICAL DISTRIBUTION EQUIPMENT.
 - ELECTRICAL CONTRACTOR TO PROVIDE ALL REQUIRED VOLTAGE REFERENCE BREAKERS FOR POWER METERING TO ENSURE FULLY FUNCTIONAL SYSTEM ON ALL METERING POINTS INDICATED.
 - PROVIDE A MINIMUM OF 10% SPARE BREAKERS AND 25% SPACE FOR ALL 600V AND 120/208V DISTRIBUTION BOARDS. MINIMUM 100A BREAKERS FOR SPARES.
- NOTES:
- ELEVATOR BREAKERS, FEEDERS AND FUSED DISCONNECT SIZED BASED ON SIZE AT TIME OF TENDER. ELECTRICAL CONTRACTOR SHALL COORDINATE EXACT BREAKER, FEEDER AND FUSED DISCONNECT SIZES WITH ELEVATOR SHOP DRAWING SUBMITTAL AT NO ADDITIONAL COST TO OWNER. ELEVATOR DISCONNECT SWITCH MUST BE LOCKABLE CW ELEVATOR RATED AUXILIARY CONTACT. IN ADDITION TO THE ELEVATOR RATED AUXILIARY CONTACT, PROVIDE AN OPEN AUXILIARY CONTACT AND A DRY CONTACT (GFI) AS REQUIRED FOR ELEVATOR CONTRACTORS USE.
 - FIRE PUMP ATS AND PUMP PACKAGE SUPPLIED BY MECHANICAL. ELECTRICAL CONTRACTOR SHALL COORDINATE EXACT SIZING AND ASSOCIATED FIRE PUMP BREAKERS AND FEEDERS WITH FIRE PUMP SHOP DRAWING SUBMITTAL.
 - PROVIDE 38" OUTDOOR RATED CAMELOCK 1016E FEMALE CONNECTION BOX FOR LOAD BANK CONNECTION.
 - GENERATOR STANDBY DISTRIBUTION SIZED TO ACCOMMODATE VOLTAGE FLEXIBILITY PER UBC REQUEST.
 - REVENUE GRADE CHECK METER FOR 7500 SERVICES TENDANT PANEL. PROVIDE QUADROLOG 500 SOCKET METER. COORDINATE WITH UBC POWER AND WATER.
 - SUMP PUMP CONTROL PANEL PROVIDED BY MECHANICAL CONTRACTOR. ELECTRICAL CONTRACTOR TO PROVIDE WIRING FROM PANEL TO PUMPS. COORDINATE WITH MECHANICAL.
 - ELECTRICAL CONTRACTOR SHALL COORDINATE EXACT BREAKER SIZE FOR SURGE PROTECTION DEVICES WITH MANUFACTURERS RECOMMENDATIONS.
 - PROVIDE GENERATOR START WIRING FROM AUTOMATIC TRANSFER SWITCH TO GENERATOR CONTROLLER. COORDINATE TERMINATION OF WIRING WITH ATS AND GENERATOR SHOP DRAWING. PROVIDE PRE AND POST TRANSFER INHIBIT WIRING FROM ATS TO ELEVATOR CONTROLLER. COORDINATE WITH ELEVATOR CONTRACTOR. PROVIDE WIRING AND RELAYS FOR ATS NOT IN AUTO SIGNAL TO BE WIRED TO GENERATOR TROUBLE SIGNAL.
 - CONTRACTOR TO SUPPLY OPTIONAL PRICING TO PROVIDE SECONDARY DISTRIBUTION SECTION ON PNT TO CATER FOR FUTURE 1200A FRAME CHOUT OFFERS DEVELOPMENT AS PART OF OPTIONAL PRICING ALLOW TO REDUCE AMPACITY OF SWBD-4N1.SD1 AND SERVICE FEEDERS TO 2000A.
 - INCOMING SERVICE SWITCHBOARD CAN BE 3 WIRE BUS 4 WIRE INCLUDED FOR UBC ENERGY AND WATERING METERING. COORDINATE WITH UBC EWS AND MANUFACTURER.
 - ELECTRICAL CONTRACTOR PROVIDE CIRCUITS FOR ALL FLOOR LISTS AS INDICATED ON FLOOR PLANS. CONTRACTOR TO ALLOW FOR COORDINATION OF EXACT LOCATIONS AS FOU REVERSE DURING CONSTRUCTION. COORDINATE EXACT LOCATIONS TO BE DETERMINED ON SITE. ELECTRICAL CONTRACTOR TO ALLOW FOR 2 ADDITIONAL FOU CONNECTIONS PER FLOOR IN ADDITION TO WHAT IS INDICATED ON DRAWINGS.
 - SPECIALTY TRANSFORMER FOR 400V LAB EQUIPMENT. TRANSFORMER TO BE COORDINATED WITH EQUIPMENT DURING CONSTRUCTION.



ISSUED	
ISSUED FOR TENDER	2022.02.04
ISSUED FOR ADD E01	2022.02.24
ISSUED FOR BUILDING PERMIT	2022.03.18
ISSUED FOR BUILDING PERMIT - PRELIMINARY REVISION	2022.07.20
ISSUED FOR CONSTRUCTION - FULL BUILDING	2022.08.19
ISSUED FOR BUILDING PERMIT	2022.08.19
ISSUED FOR CON405	2022.11.21
ISSUED FOR CON406.R1	2023.03.29
ISSUED FOR CON410	2023.03.29
ISSUED FOR CON412	2023.03.29
ISSUED FOR CON413	2023.07.11
ISSUED FOR CON439	2024.08.31
ISSUED FOR CON439	2024.12.18
ISSUED FOR CON451	2025.03.10
ISSUED FOR GEN	2025.04.09
ISSUED FOR CON458	2025.09.23

KEYPLAN

PROJECT

UBC Gateway Building
5955 University Boulevard
Vancouver BC V6T 1Z1

PROJECT NUMBER

20197.000

REVISIONS

TITLE

SINGLE LINE DIAGRAM

SHEET NUMBER

E02-00